

PERMIT

Permit No:

200802467-JW

Municipality:

Essex

Work Area:

North Cove off property located at 7 Hanna Lane

Permittee:

James Rawn 7 Hanna Lane Essex, CT 06426

Pursuant to sections 22a-359 through 22a-363f of the Connecticut General Statutes ("CGS") and in accordance with 22a-98 the Connecticut Water Quality Standards dated December 2002, a permit is hereby granted by the Commissioner of Environmental Protection ("Commissioner") to retain an existing dock for canoe and kayak access and to retain an existing bulkhead for shoreline flood and erosion control as is more specifically described below in the <u>SCOPE OF AUTHORIZATION</u>, in North Cove off property identified as the "work area" above.

*****<u>NOTICE TO PERMITTEES AND CONTRACTORS</u>*****

FAILURE TO CONFORM TO THE TERMS AND CONDITIONS OF THIS PERMIT MAY SUBJECT THE PERMITTEE AND ANY CONTRACTOR TO ENFORCEMENT ACTIONS, INCLUDING PENALTIES AND INJUNCTIONS, AS PROVIDED BY LAW.

SCOPE OF AUTHORIZATION

The Permittee is hereby authorized to conduct the following work as described in application #200802467-JW, including 2 sheets of plans dated June 8, 2008, submitted by the Permittee to the Commissioner and attached hereto, as follows:

1. retain an existing 3' x 27' fixed pier and an existing 37 linear foot timber bulkhead;

UPON INITIATION OF ANY WORK AUTHORIZED HEREIN, THE PERMITTEE ACCEPTS AND AGREES TO COMPLY WITH ALL TERMS AND CONDITIONS OF THIS PERMIT.

SPECIAL TERMS AND CONDITIONS

- 1. Except as specifically authorized by this permit, no equipment or material, including but not limited to, fill, construction materials, excavated material or debris, shall be deposited, placed or stored in any wetland or watercourse on or off-site, nor shall any wetland or watercourse be used as a staging area or accessway other than as provided herein.
- 2. Not later than two weeks prior to the commencement of any work authorized herein, the Permittee shall submit to the Commissioner, on the form attached hereto as Appendix A, the name(s) and



- address(es) of any contractor(s) employed to conduct such work and the expected date for commencement and completion of such work.
- 3. The Permittee shall give a copy of this permit to the contractor(s) who will be carrying out the activities authorized herein prior to the start of construction and shall receive a written receipt for such copy, signed and dated by such contractor(s). The Permittee's contractor(s) shall conduct all operations at the site in full compliance with this permit and, to the extent provided by law, may be held liable for any violation of the terms and conditions of this permit.
- 4. Not later than 30 days after issuance of this permit the Permittee shall modify the decking on the fixed pier authorized herein such that all planks are spaced 1.5" apart.
- 5. The Permittee shall not berth, even temporarily, any power operated vessel at the fixed pier authorized herein.

GENERAL TERMS AND CONDITIONS

- 1. All work authorized by this permit shall be completed within thirty days from date of issuance of this permit ("work completion date") in accordance with all conditions of this permit and any other applicable law.
- 2. In conducting the work authorized herein, the Permittee shall not deviate from the attached plans, as may be modified by this permit. The Permittee shall not make de minimis changes from said plans without prior written approval of the Commissioner.
- 3. The Permittee shall maintain all structures or other work authorized herein in good condition. Any such maintenance shall be conducted in accordance with applicable law including, but not limited to, CGS sections 22a-28 through 22a-35 and CGS sections 22a-359 through 22a-363f.
- 4. Prior to the commencement of any work authorized hereunder, the Permittee shall cause a copy of this permit to be given to any contractor(s) employed to conduct such work. At the work area the Permittee shall, whenever work is being performed, make available for inspection a copy of this permit and the final plans for the work authorized herein.
- 5. The Permittee shall notify the Commissioner in writing of the commencement of any work and completion of all work authorized herein no later than three days prior to the commencement of such work and no later than seven days after the completion of such work.
- 6. All waste material generated by the performance of the work authorized herein shall be disposed of by the Permittee at an upland site approved for the disposal of such waste material, as applicable.
- 7. In undertaking the work authorized hereunder, the Permittee shall not cause or allow pollution of wetlands or watercourses, including pollution resulting from sedimentation and erosion. For purposes of this permit, "pollution" means "pollution" as that term is defined by CGS section 22a-423.
- 8. Upon completion of any work authorized herein, the Permittee shall restore all areas impacted by



construction, or used as a staging area or accessway in connection with such work, to their condition prior to the commencement of such work.

9. Any document required to be submitted to the Commissioner under this permit or any contact required to be made with the Commissioner shall, unless otherwise specified in writing by the Commissioner, be directed to:

Permit Section
Office of Long Island Sound Programs
Department of Environmental Protection
79 Elm Street
Hartford, Connecticut 06106-5127
(860) 424-3034
Fax # (860) 424-4054

- 10. The date of submission to the Commissioner of any document required by this permit shall be the date such document is received by the Commissioner. The date of any notice by the Commissioner under this permit, including but not limited to notice of approval or disapproval of any document or other action, shall be the date such notice is personally delivered or the date three days after it is mailed by the Commissioner, whichever is earlier. Except as otherwise specified in this permit, the word "day" as used in this permit means calendar day. Any document or action which is required by this permit to be submitted or performed by a date which falls on a Saturday, Sunday or a Connecticut or federal holiday shall be submitted or performed on or before the next day which is not a Saturday, Sunday, or a Connecticut or federal holiday.
- 11. The work specified in the <u>SCOPE OF AUTHORIZATION</u> is authorized solely for the purpose set out in this permit. No change in the purpose or use of the authorized work or facilities as set forth in this permit may occur without the prior written authorization of the Commissioner. The Permittee shall, prior to undertaking or allowing any change in use or purpose from that which is authorized by this permit, request authorization from the Commissioner for such change. Said request shall be in writing and shall describe the proposed change and the reason for the change.
- 12. This permit may be revoked, suspended, or modified in accordance with applicable law.
- 13. This permit is not transferable without prior written authorization of the Commissioner. A request to transfer a permit shall be submitted in writing and shall describe the proposed transfer and the reason for such transfer. The Permittee's obligations under this permit shall not be affected by the passage of title to the work area to any other person or municipality until such time as a transfer is authorized by the Commissioner.
- 14. The Permittee shall allow any representative of the Commissioner to inspect the work authorized herein at reasonable times to ensure that it is being or has been accomplished in accordance with the terms and conditions of this permit.
- 15. In granting this permit, the Commissioner has relied on representations of the Permittee, including information and data provided in support of the Permittee's application. Neither the Permittee's representations nor the issuance of this permit shall constitute an assurance by the Commissioner as to the structural integrity, the engineering feasibility or the efficacy of such design.



- 16. In the event that the Permittee becomes aware that he did not or may not comply, or did not or may not comply on time, with any provision of this permit or of any document required hereunder, the Permittee shall immediately notify the Commissioner and shall take all reasonable steps to ensure that any noncompliance or delay is avoided or, if unavoidable, is minimized to the greatest extent possible. In so notifying the Commissioner, the Permittee shall state in writing the reasons for the noncompliance or delay and propose, for the review and written approval of the Commissioner, dates by which compliance will be achieved, and the Permittee shall comply with any dates which may be approved in writing by the Commissioner. Notification by the Permittee shall not excuse noncompliance or delay and the Commissioner's approval of any compliance dates proposed shall not excuse noncompliance or delay unless specifically stated by the Commissioner in writing.
- 17. In evaluating the application for this permit the Commissioner has relied on information and data provided by the Permittee and on the Permittee's representations concerning site conditions, design specifications and the proposed work authorized herein, including but not limited to representations concerning the commercial, public or private nature of the work or structures authorized herein, the water-dependency of said work or structures, its availability for access by the general public, and the ownership of regulated structures or filled areas. If such information proves to be false, deceptive, incomplete or inaccurate, this permit may be modified, suspended or revoked, and any unauthorized activities may be subject to enforcement action.
- 18. The Permittee may not conduct work waterward of the high tide line or in tidal wetlands at this permit site other than the work authorized herein, unless otherwise authorized by the Commissioner pursuant to CGS section 22a-359 et. seq. and/or CGS section 22a-32 et. seq.
- 19. The issuance of this permit does not relieve the Permittee of his obligations to obtain any other approvals required by applicable federal, state and local law.
- 20. Any document, including but not limited to any notice, which is required to be submitted to the Commissioner under this permit shall be signed by the Permittee and by the individual or individuals responsible for actually preparing such document, each of whom shall certify in writing as follows: "I have personally examined and am familiar with the information submitted in this document and all attachments and certify that based on reasonable investigation, including my inquiry of those individuals responsible for obtaining the information, the submitted information is true, accurate and complete to the best of my knowledge and belief, and I understand that any false statement made in this document or its attachments may be punishable as a criminal offense."
- 21. This permit is subject to and does not derogate any present or future property rights or powers of the State of Connecticut, and conveys no property rights in real estate or material nor any exclusive privileges, and is further subject to any and all public and private rights and to any federal, state or local laws or regulations pertinent to the property or activity affected hereby.



Issued on	, 2009

STATE OF CONNECTICUT DEPARTMENT OF ENVIRONMENTAL PROTECTION

Betsey Wingfield
Bureau Chief
Bureau of Water Protection and Land Reuse

Permit Application No. 200802467-JW James Rawn

Certified Mail #_____

OFFICE OF LONG ISLAND SOUND PROGRAMS

APPENDIX A

TO: Permit Section

Department of Environmental Protection Office of Long Island Sound Programs

79 Elm Street

Hartford, CT 06106-5127

PERMITTEE:


Mr. James Rawn

James Rawn 7 Hanna Lane Essex, CT 06426

Permit No:

200802467-JW, Essex

CONTRACTOR 1:		
Address:		
Telephone #:		
CONTRACTOR 2:		
Address:		
Telephone #:		
CONTRACTOR 3:		
Address:		
Telephone #:		
EXPECTED DATE OF	COMMENCEMENT OF V	VORK:
EXPECTED DATE OF	COMPLETION OF WORL	K:
PERMITTEE:		
	(signature)	(date)

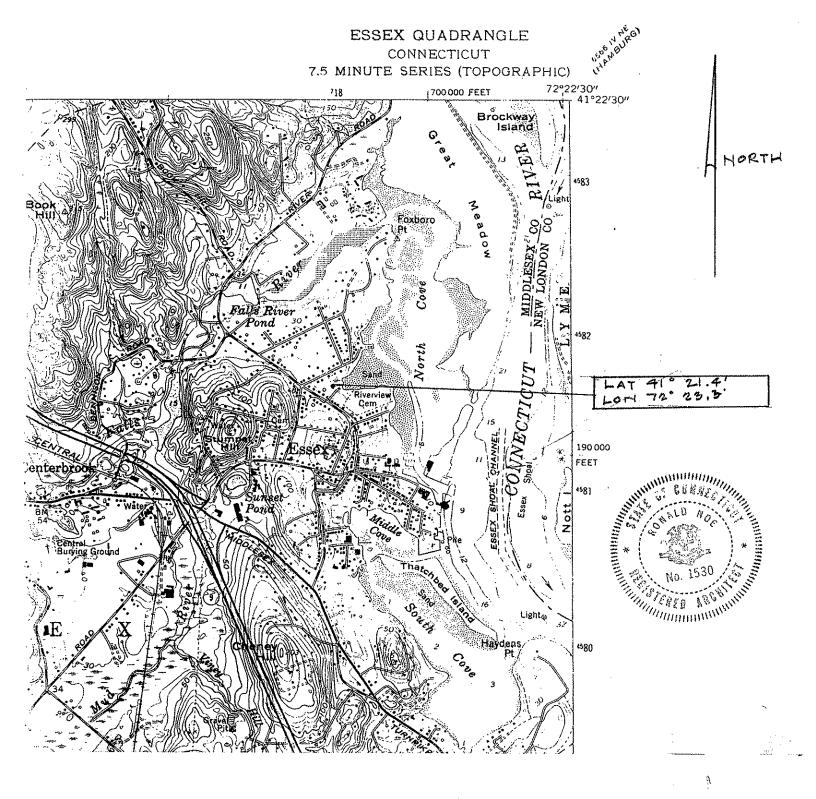

VICINITY MAP

APPLICANT: JAMES RAWN

7 HANNA LANE


ESSEX, CONNECTICUT 06426

DATE: 06-08-08

RONALD K. NOE, ARCHITECT

SCALE: 1:24000

DRAWING NUMBER: 1 OF 5

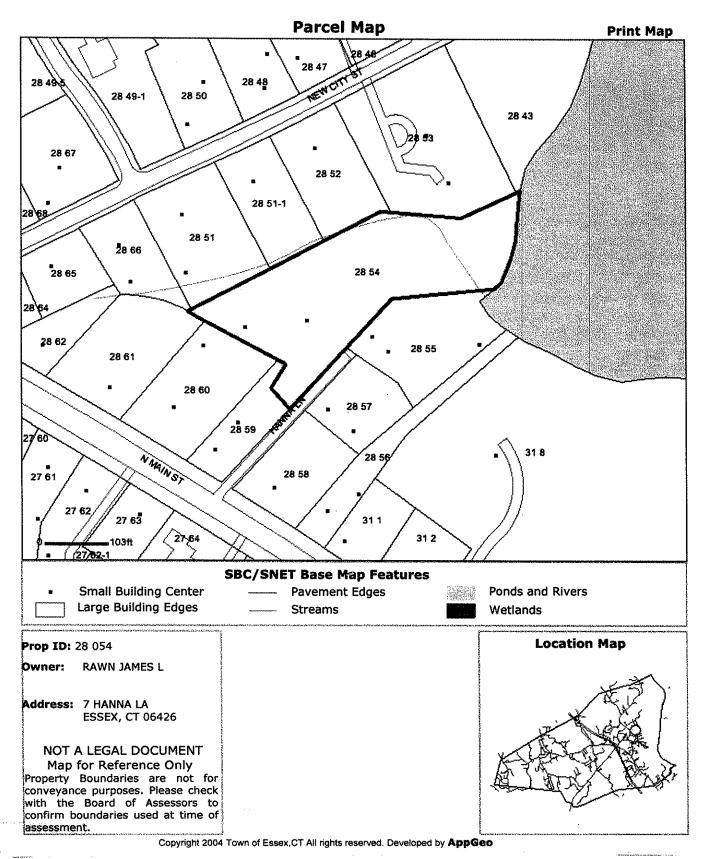

PARCEL MAP AND LOCATION MAP

APPLICANT: JAMES RAWN 7 HANNA LANE

ESSEX, CONNECTICUT 06426

DATE: 06-08-08

RONALD K. NOE, ARCHITECT

SCALE AS NOTED

DRAWING NUMBER: Z OF 5



Prop ID: 28 054 Location Map

Owner: RAWN JAMES L

Address: 7 HANNA LA

ESSEX, CT 06426

NOT A LEGAL DOCUMENT
Map for Reference Only
Property Boundaries are not for
conveyance purposes. Please check
with the Board of Assessors to
confirm boundaries used at time of
assessment.

Copyright 2004 Town of Essex.CT All rights reserved. Developed by AppGeo

PARCEL ORTHOPHOTO MAP

APPLICANT: JAMES RAWN

7 HANNA LANE

ESSEX: CONNECTICUT 36424

DATE: 04-08-08

 $\mathbb{F}(X(\Delta_{n}, T), \mathcal{F}_{n}) \to \mathbb{F}_{T_{n}} \times \mathbb{F}_{T_{n}} \times \mathbb{F}_{T_{n}}$



Location Map Prop ID: 28 054

Owner: RAWN JAMES L

Address: 7 HANNA LA ESSEX, CT 06426

NOT A LEGAL DOCUMENT Map for Reference Only Property Boundaries are not for conveyance purposes. Please check with the Board of Assessors to confirm boundaries used at time of assessment.

Copyright 2004 Town of Essex CT All rights reserved. Developed by AppGeo

PARCEL ORTHOPHOTO MAP


APPLICANT: JAMES RAWN

7 HANNA LANE

ESSEX: CONNECTION 16424

DATE: 96-08-08

STALE AS NOTED DEVALUABLE

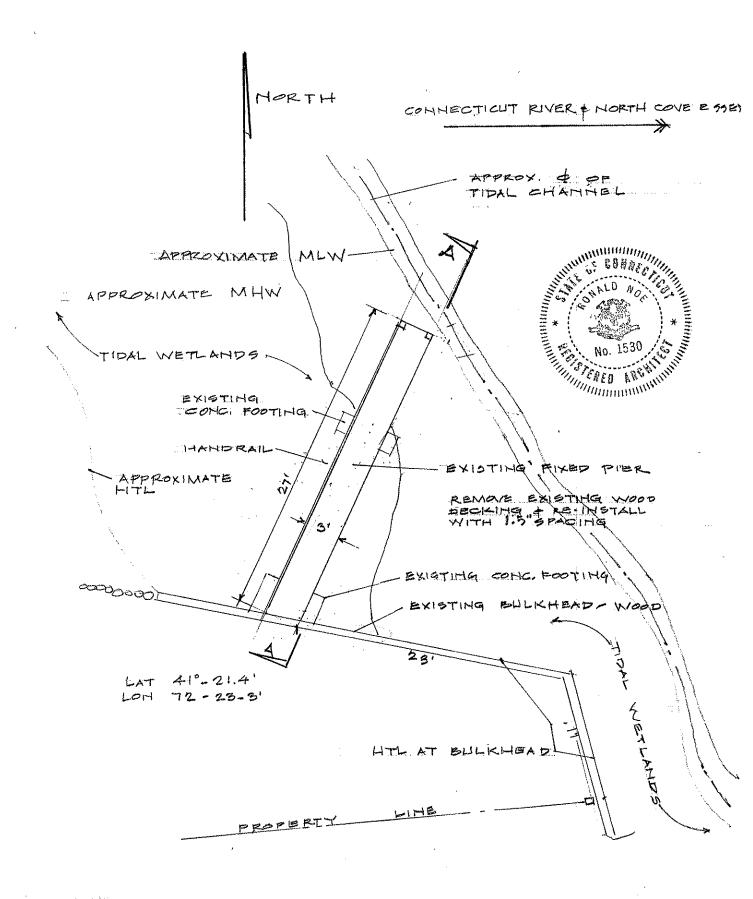

DETAIL PLAN VIEW OF EXISTING PIER & BULKHEAD

APPLICANT: JAMES RAWN


7 HANNA LANE

ESSEX, CONNECTICUT 06426

DATE: 06-08-08

RONALD K. NOE, ARCHITECT

SCALE: 1/8" = 1'-0" DRAWING NUMBER: 4 OF 5

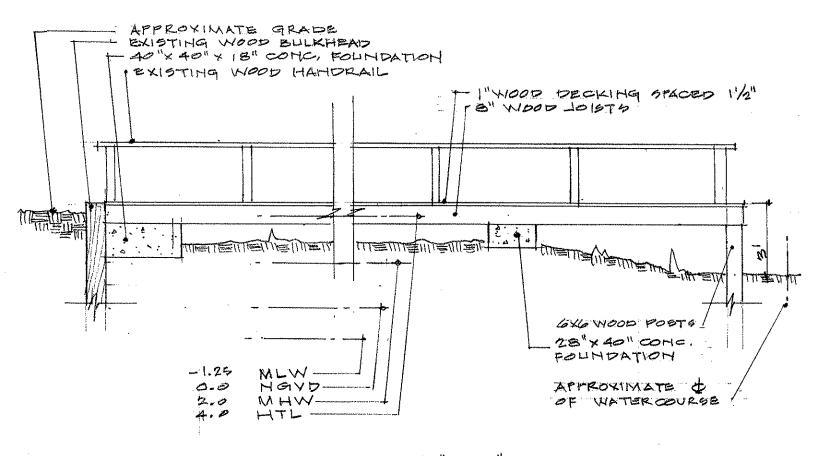

SECTION "A-A"

SECTION "A-A"

APPLICANT: JAMES RAWN

7 HANNA LANE

ESSEX, CONNECTICUT 06426

DATE: 06-08-08

RONALD K. NOE, ARCHITECT

SCALE: 1/4" = 1'-0" DRAWING NUMBER: 5 OF 5

Rev. 12/10/99

Latitude and Longitude

	Transmittal Form)
Applicant Name: James Rawn	(as indicated on the <i>Permit Application Transmittal Form</i>)

k one):
(check
nation
determination (check
<i>a</i> s
and longitude
of latitude
od of la
/lethc

Global Positioning System (GPS)

 \boxtimes

In the table below, label each point for which latitude and longitude were measured, being consistent with identification numbers assigned	throughout the application (e.g., 100, 101, etc.). For renewals or modifications of existing permits, please provide the existing permit number. Also	provide: a brief description of the point (e.g., monitoring well, pipe outlet, air stack, etc.); latitude and longitude in degrees, minutes and seconds	of the USGS quadrangle map(s) the points described are located on.
In the table below, label each point for which latitude and longitud	throughout the application (e.g., 100, 101, etc.). For renewals or r	provide: a brief description of the point (e.g., monitoring well, pipe	(e.g., 41E 16' 29"); and the name of the USGS quadrangle map(s) the points described are located on.

Other (please specify)

USGS Map

For DEP Use Only: GIS ID				
Quad Map Name	Essex			
Longitude	72 23.3'			
Latitude	41 21.4'			
Description	Fixed Pier at 7 Hanna Lane, Essex			
Permit Number	Pending			
ID Number				